



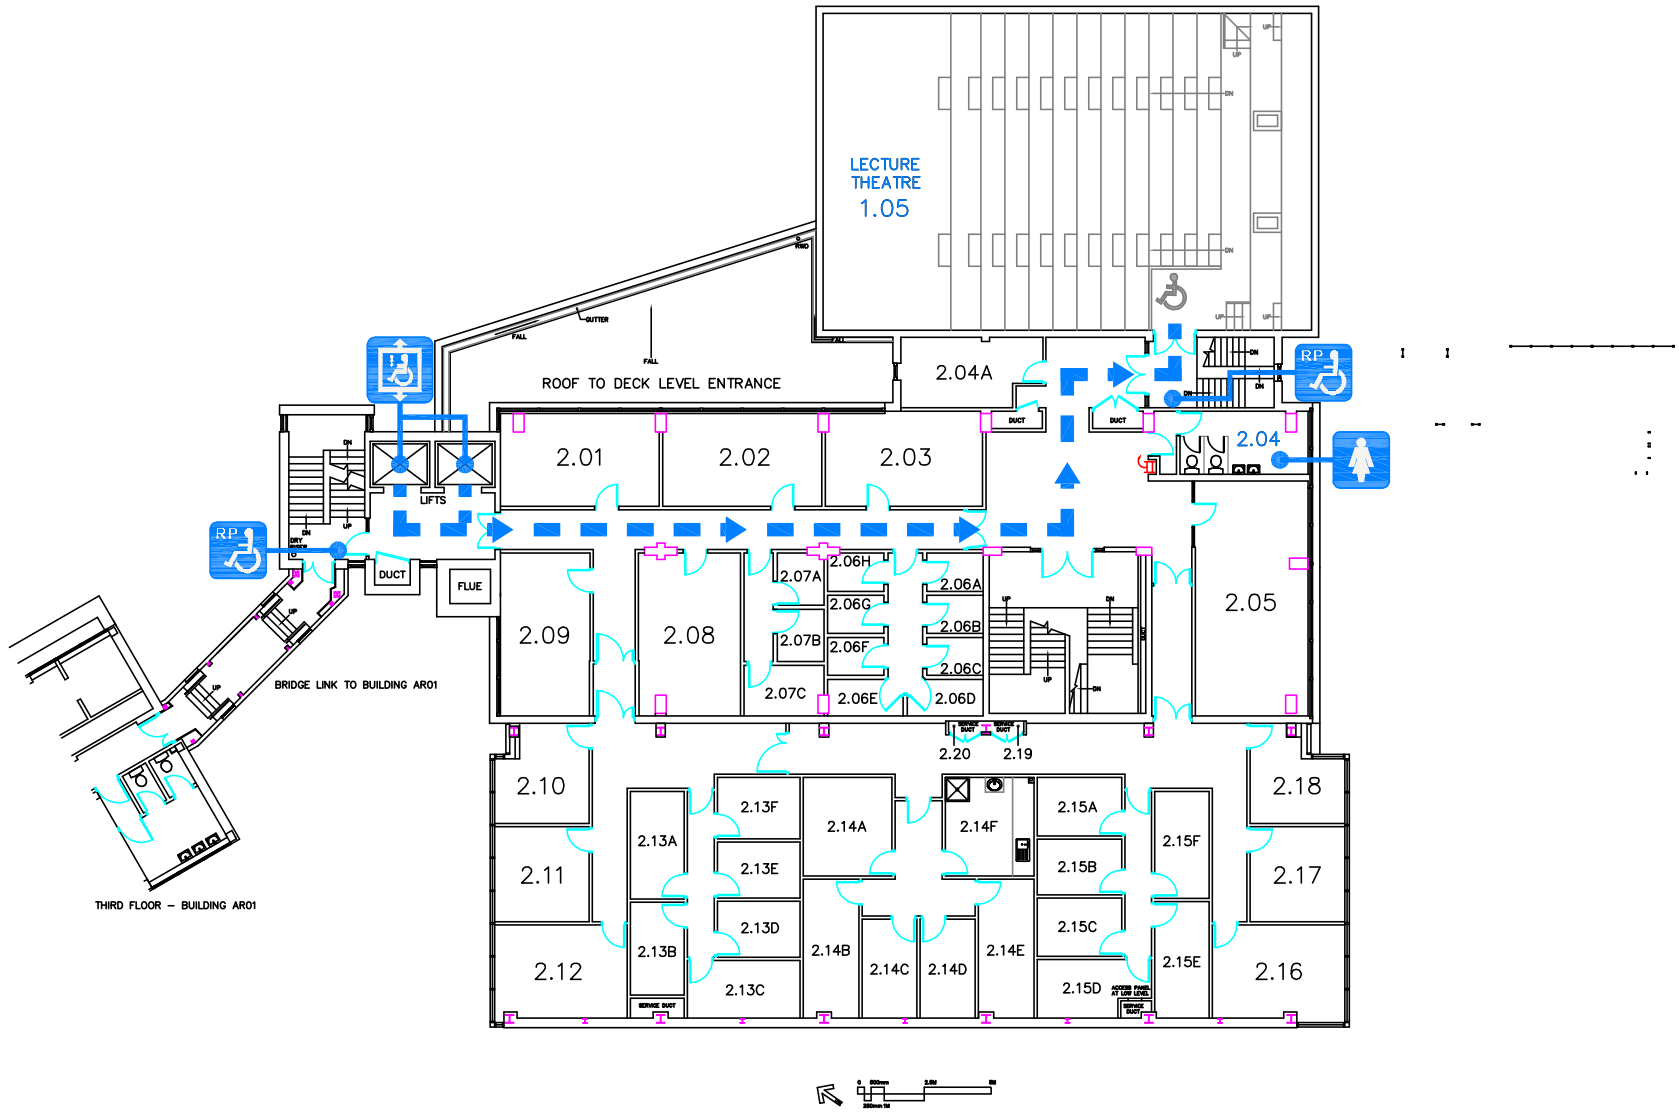


ACCESSIBILITY LEGEND	
	FEMALE TOILET
	ACCESSIBLE LIFT
	REFUGE POINT
	ACCESSIBLE ROUTE



ACCESSIBILITY LAYOUT.  
 LAST UPDATED - 27/01/2009  
 DETAILS SUPPLIED BY - S. THOMAS  
 DRAWN BY - RLF

ESTATES DIVISION

CARDIF UNIVERSITY  
 PRIFYSGO CAERDYF

TITLE  
 TOWER BUILDING,  
 SECOND FLOOR PLAN.

ACCESSIBILITY LAYOUT.

SCALE  
 1:200\A3 SHEET ORIGINAL LAYOUT DRAWN  
 GPI

LAST REVISED: RLF - 27/01/2009  
 DRAWN/DATE

REC. DWG. No. AR\AR02\FP\02

RECORD DRAWING