

ACCESSIBILITY LAYOUT.
 LAST UPDATED - 19/02/2009
 DETAILS SUPPLIED BY - S. THOMAS
 DRAWN BY - RLF

MUSEUM AVENUE

ACCESSIBILITY LEGEND	
	INDUCTION LOOP SYSTEM
	ACCESSIBLE UNISEX TOILET
	MALE TOILET
	FEMALE TOILET
	RAMP ACCESS
	ACCESSIBLE LIFT
	ACCESSIBLE ROUTE

CARDIFF UNIVERSITY
PRIFYSGOL CARDIFF



Estates

Title
**LAW BUILDING.
 GROUND FLOOR PLAN.**

ACCESSIBILITY LAYOUT.

Scale: 1:200\A3 SHEET	Original Layout Drawn: GPI
Last Revised Drawn/Date:	RLF - 07/02/2017
Rec. Drg. No.:	AR\AR01\FP\00

Record Drawing

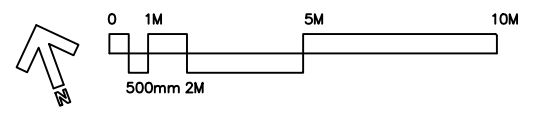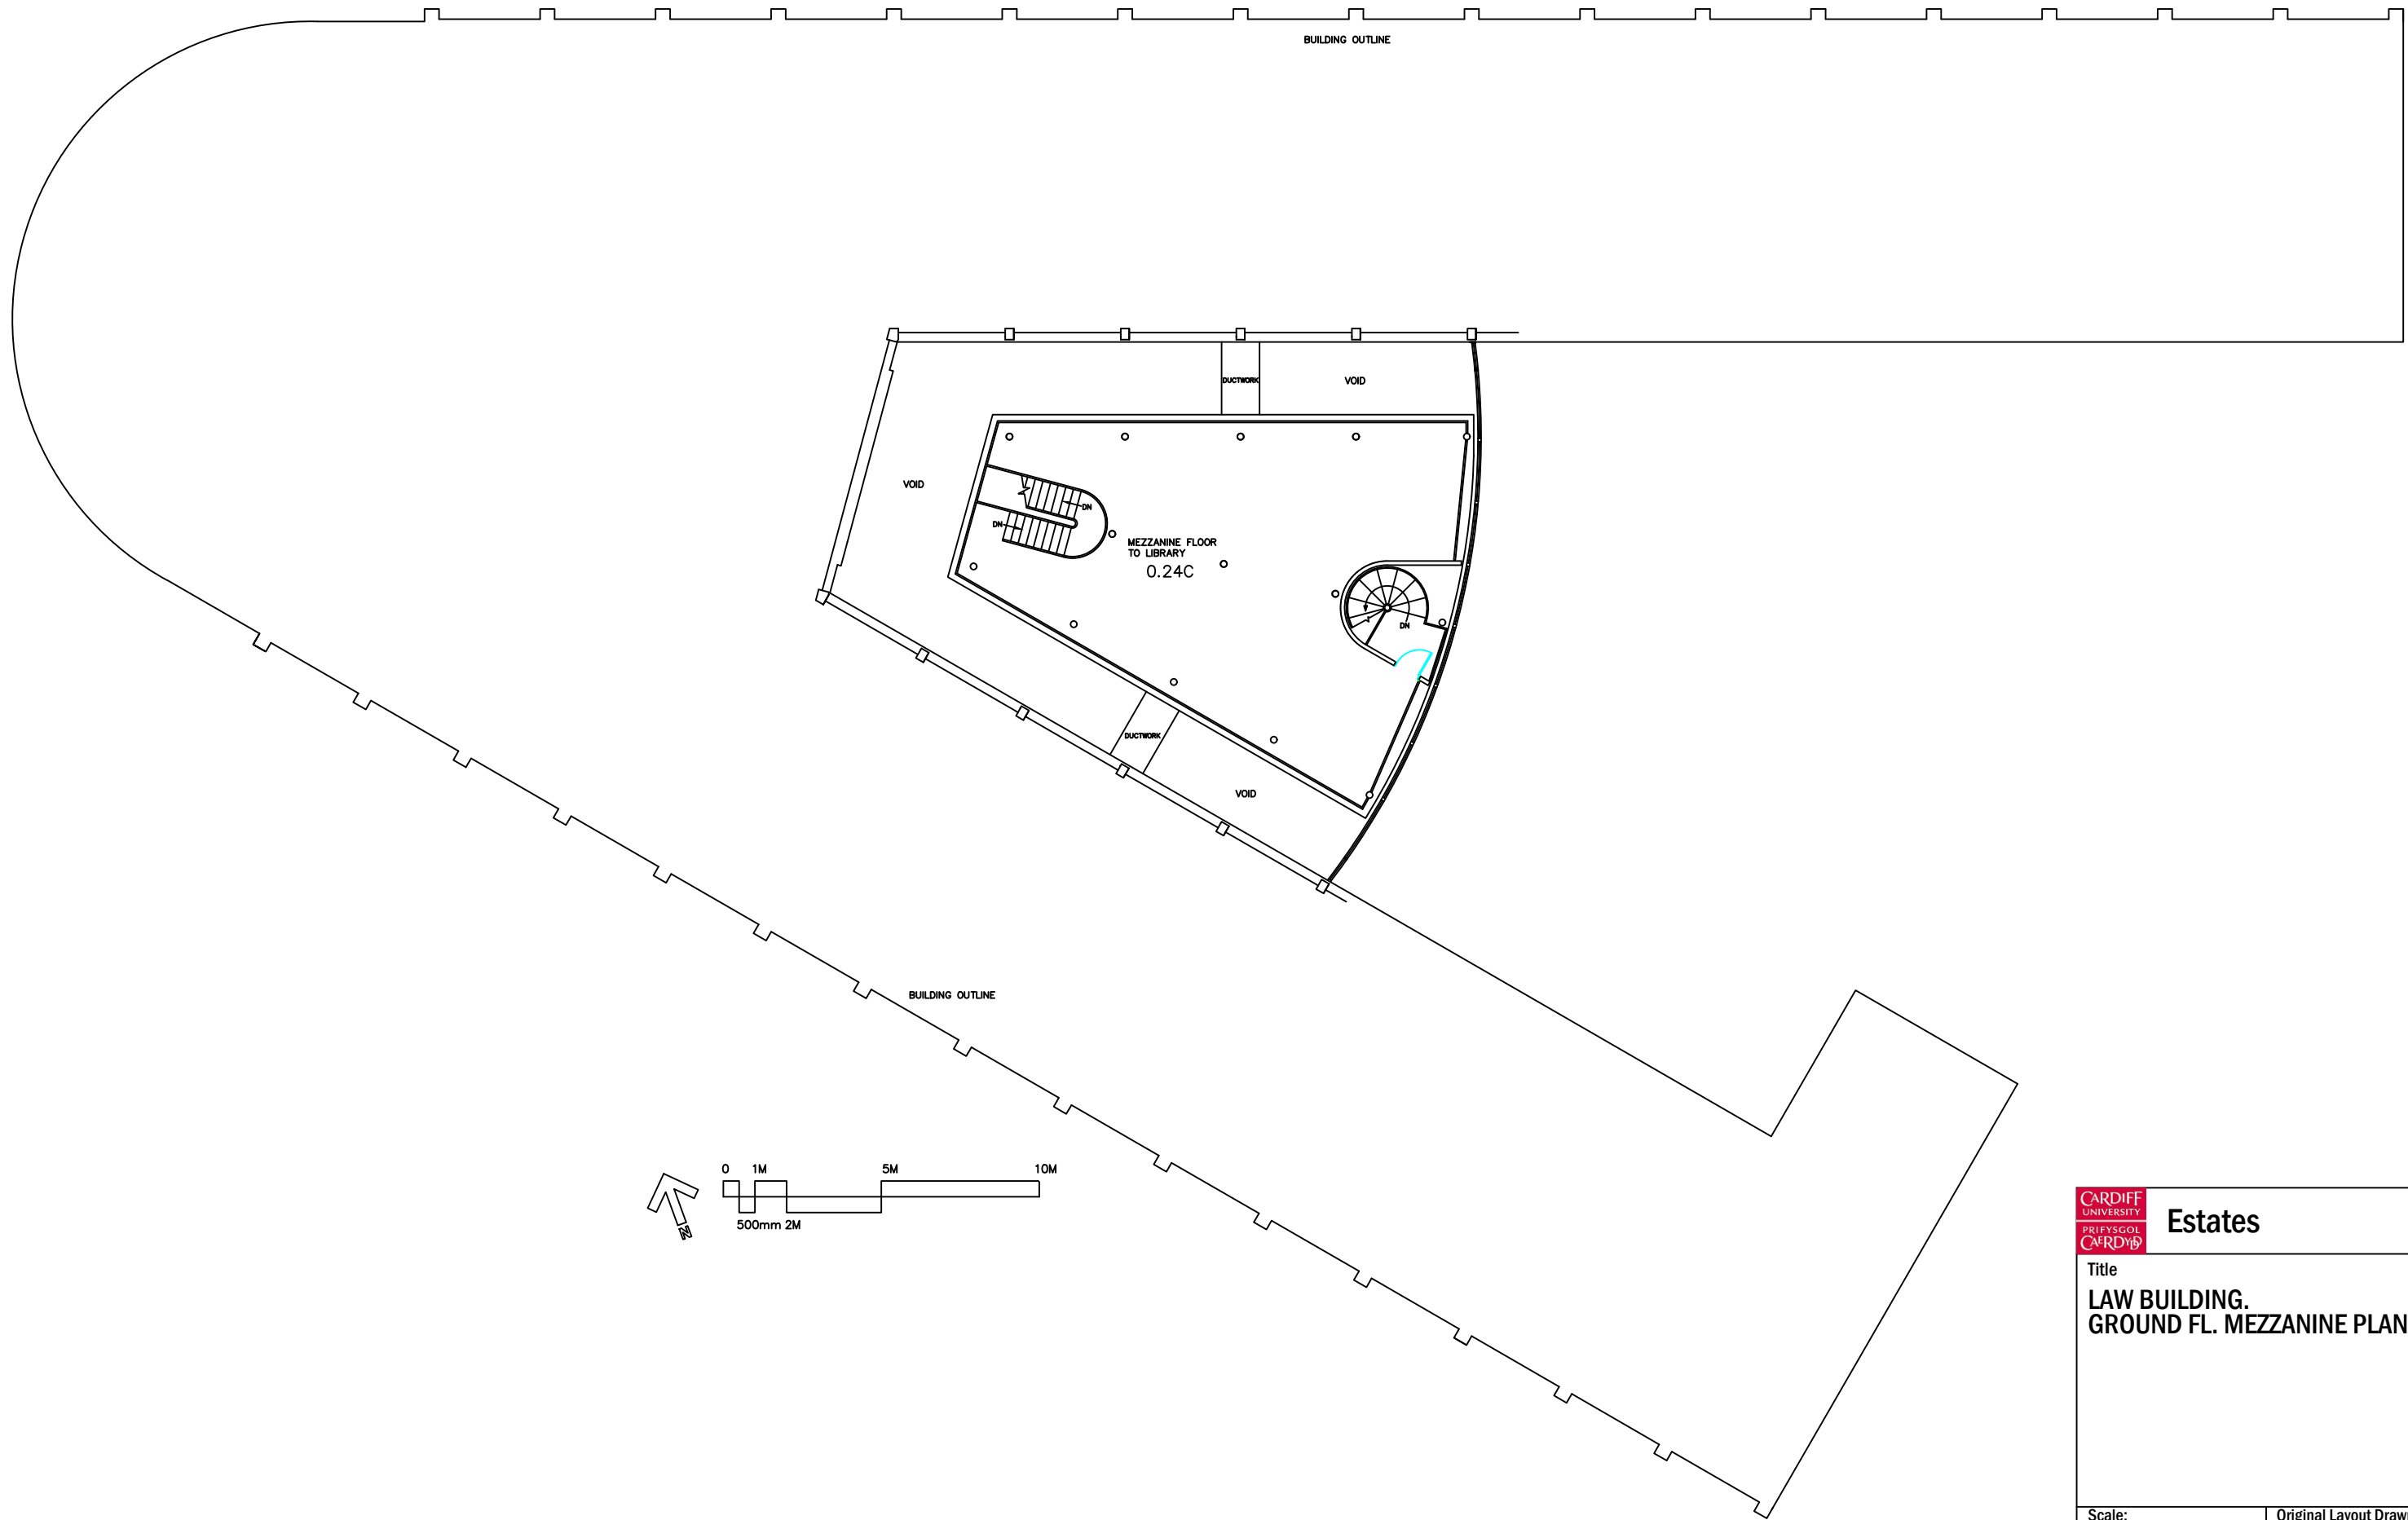


 Estates	
Title LAW BUILDING. GROUND FL. MEZZANINE PLAN.	
Scale: 1:200\A3 SHEET	Original Layout Drawn: GPI
Last Revised Drawn/Date:	DJC - 18/10/2006
Rec. Drg. No.:	AR\AR01\FP\00M
Record Drawing	



ACCESSIBILITY LEGEND	
	ACCESSIBLE UNISEX TOILET
	MALE TOILET
	FEMALE TOILET
	ACCESSIBLE LIFT
	REFUGE POINT
	ACCESSIBLE ROUTE


ACCESSIBILITY LAYOUT.
 LAST UPDATED - 10/02/2009
 DETAILS SUPPLIED BY - S. THOMAS
 DRAWN BY - RLF

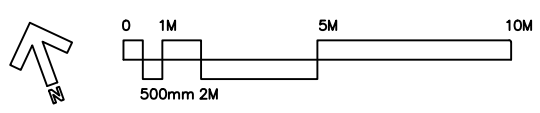

 Estates	Title LAW BUILDING. FIRST FLOOR PLAN.
	ACCESSIBILITY LAYOUT.
Scale: 1:200\A3 SHEET	Original Layout Drawn: GPI
Last Revised Drawn/Date: RE - 29/09/2014	Rec. Drg. No.: AR\AR01\FP\01
Record Drawing	



ACCESSIBILITY LEGEND	
	MALE TOILET
	FEMALE TOILET
	ACCESSIBLE LIFT
	REFUGE POINT
	ACCESSIBLE ROUTE

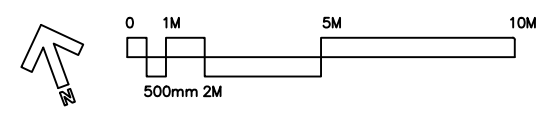

ACCESSIBILITY LAYOUT.
 LAST UPDATED - 11/02/2009
 DETAILS SUPPLIED BY - S. THOMAS
 DRAWN BY - RLF


 Estates	Title
	LAW BUILDING. SECOND FLOOR PLAN.
ACCESSIBILITY LAYOUT.	
Scale: 1:200\A3 SHEET	Original Layout Drawn: GPI
Last Revised Drawn/Date:	RLF - 05/06/2015
Rec. Drg. No.:	AR\AR01\FP\02
Record Drawing	




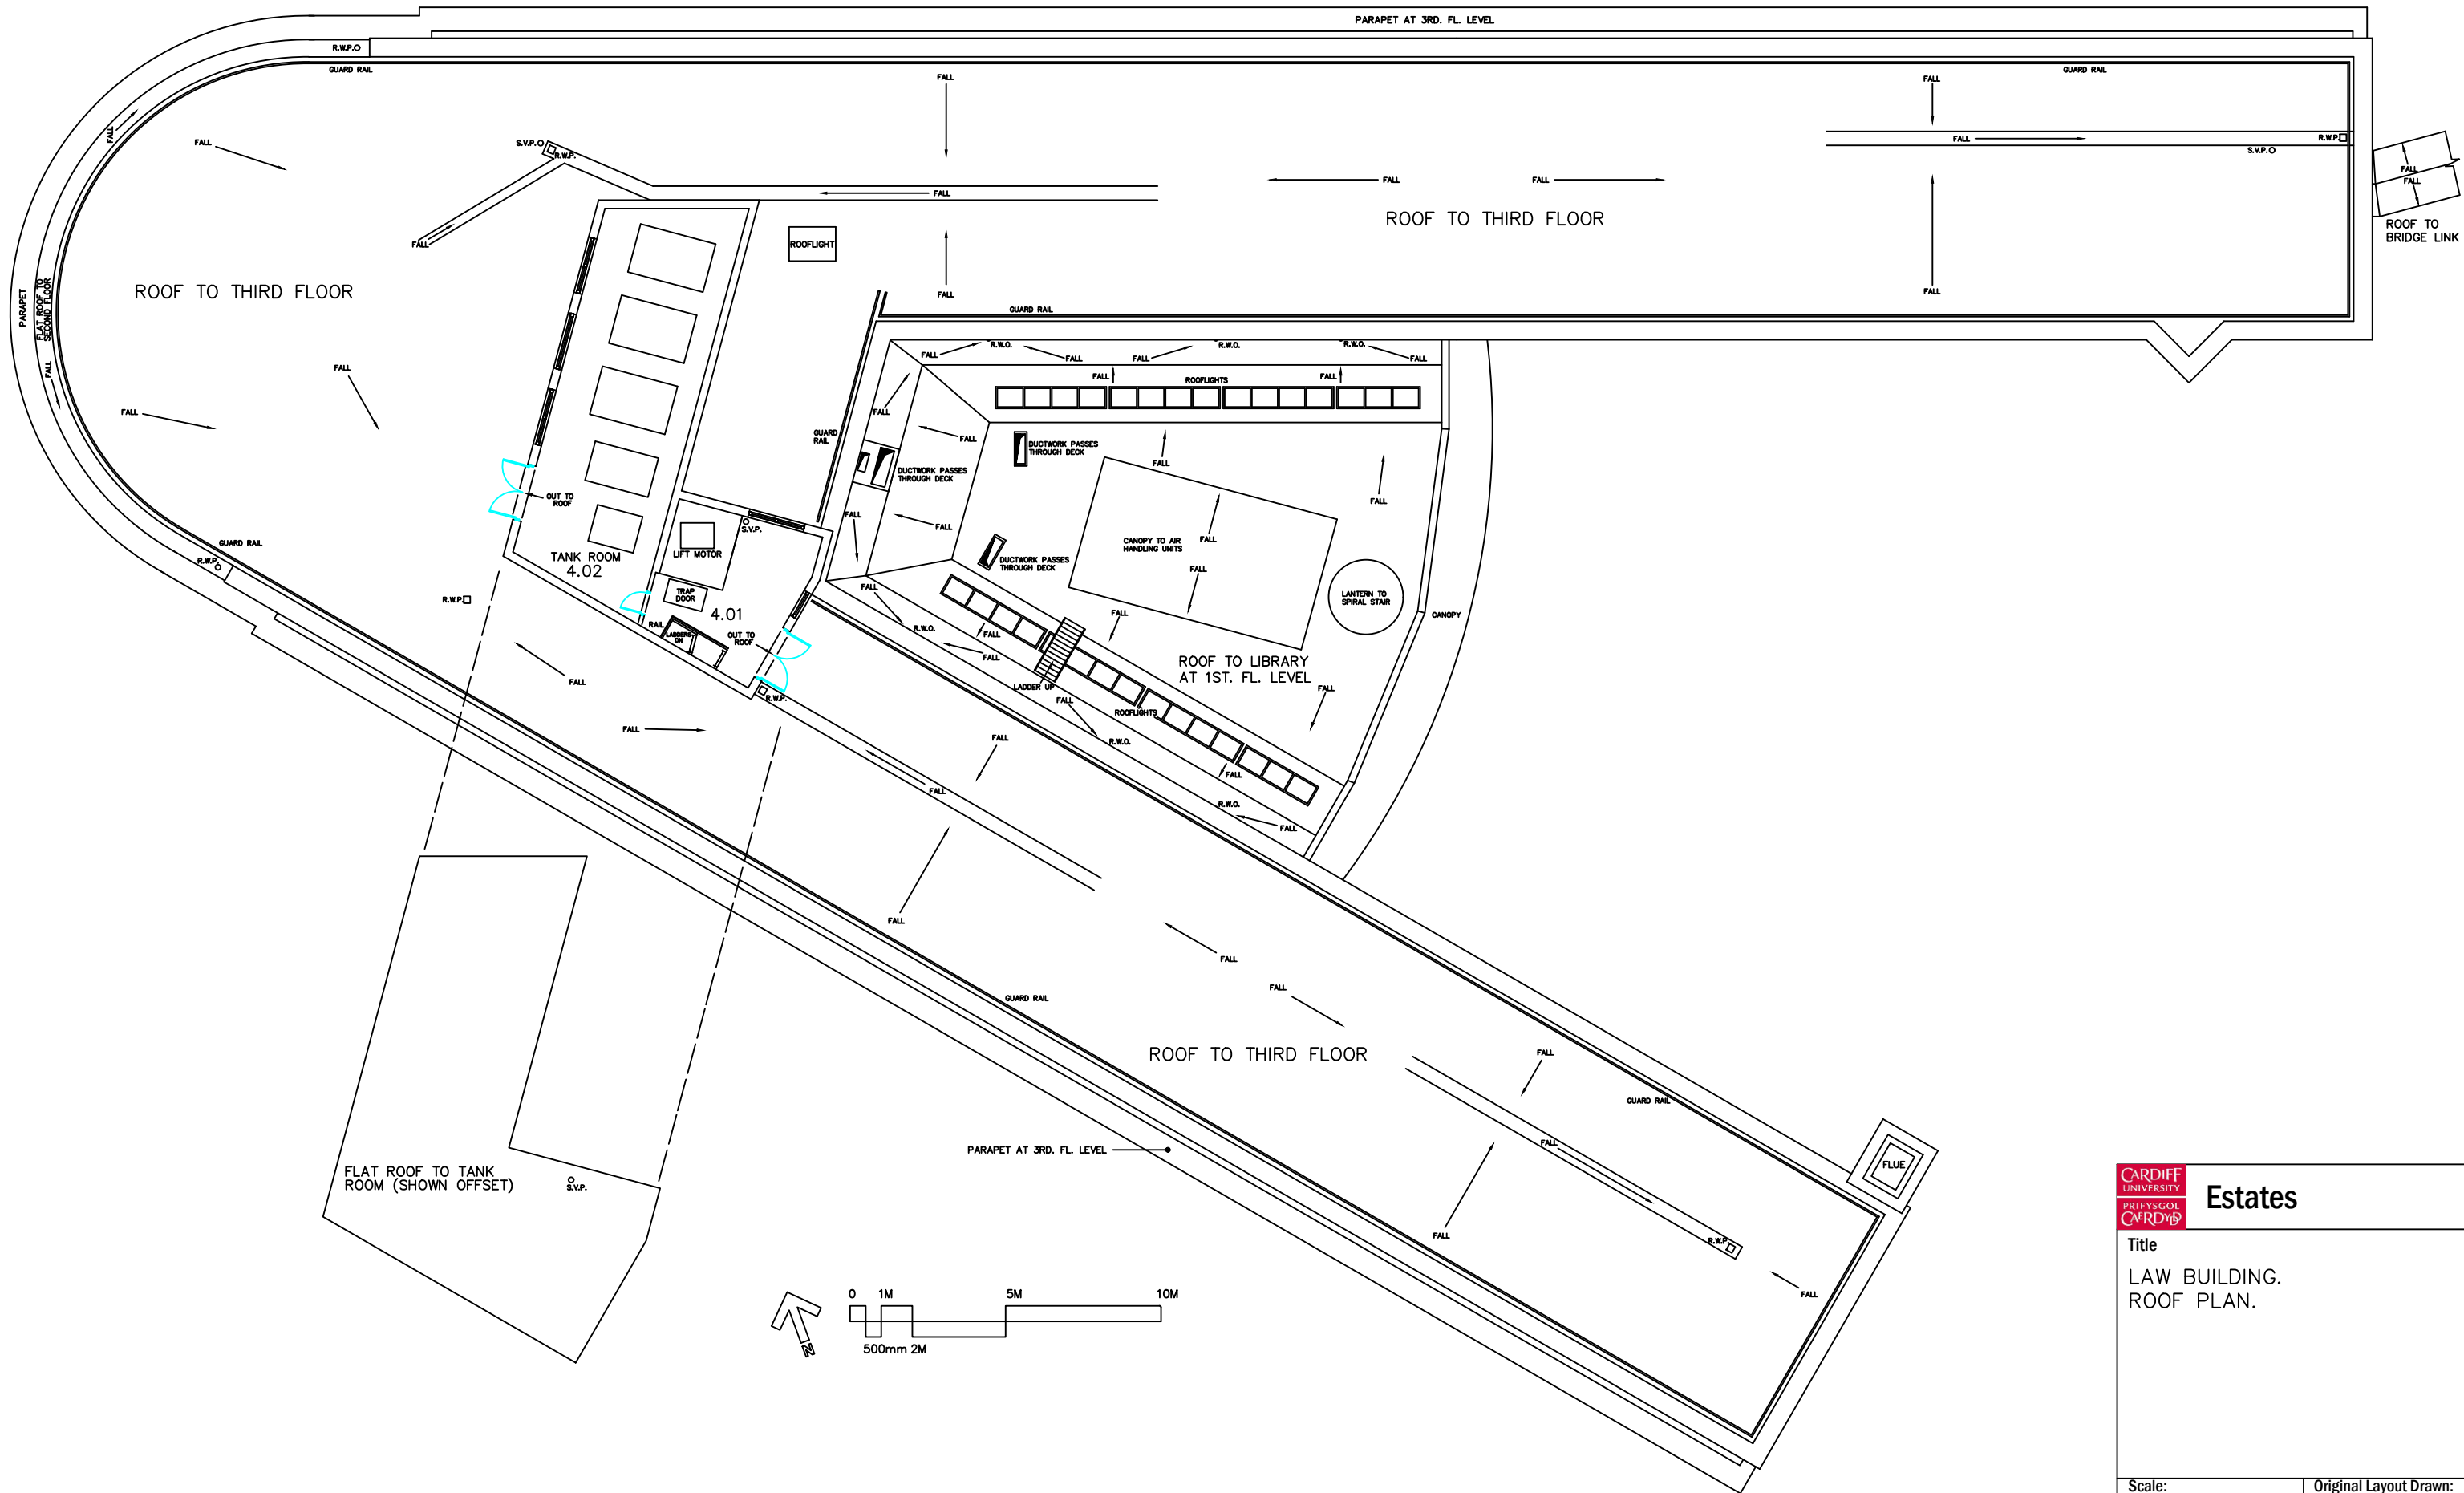
ACCESSIBILITY LEGEND	
	MALE TOILET
	FEMALE TOILET
	ACCESSIBLE LIFT
	REFUGE POINT
	ACCESSIBLE ROUTE

ACCESSIBILITY LAYOUT.
 LAST UPDATED - 11/02/2009
 DETAILS SUPPLIED BY - S. THOMAS
 DRAWN BY - RLF

	Estates
	Title LAW BUILDING. SECOND FLOOR PLAN. ACCESSIBILITY LAYOUT.
Scale: 1:100\A1 SHEET	Original Layout Drawn: GPI
Last Revised Drawn/Date: RLF - 05/06/2015	
Rec. Drg. No.: AR\AR01\FP\02	
Record Drawing	

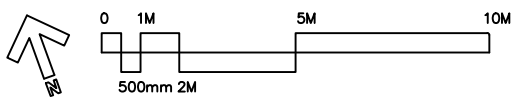

 Estates	
Title LAW BUILDING. THIRD FLOOR PLAN.	
Scale: 1:200\A3 SHEET	Original Layout Drawn: GPI
Last Revised Drawn/Date:	RLF - 04/06/2015
Rec. Drg. No.:	AR\AR01\FP\03
Record Drawing	



Title
LAW BUILDING.
ROOF PLAN.

Scale: 1: 200\A3 SHEET	Original Layout Drawn: GPI
Last Revised Drawn/Date: GPI - 06/06/2001	
Rec. Drg. No.:	AR\AR01\FP\04R